


AERIAL VIEW

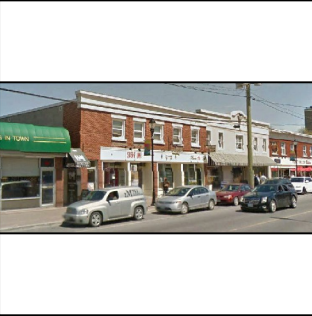

EXTERIOR VIEW

LEGEND:



- EXISTING WALLS
- EP ELECTRICAL PANEL
- HW HOT WATER TANK

PREPARED FOR: The Properties Group Management Ltd.
ADDRESS: 1307 Wellington St., Ottawa, ON
DATE: January 14, 2015
REVISION: n/a
PROJECT NUMBER: 102000
DRAWING SCALE: 8.5" x 14" - Legal Size



ECHO FLOOR PLANS
■ As-Built Floor Plans
■ Area Analysis
■ Space Planning
www.ECHOFloorPlans.com

WELLINGTON STREET

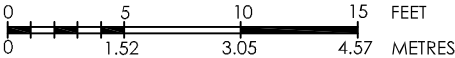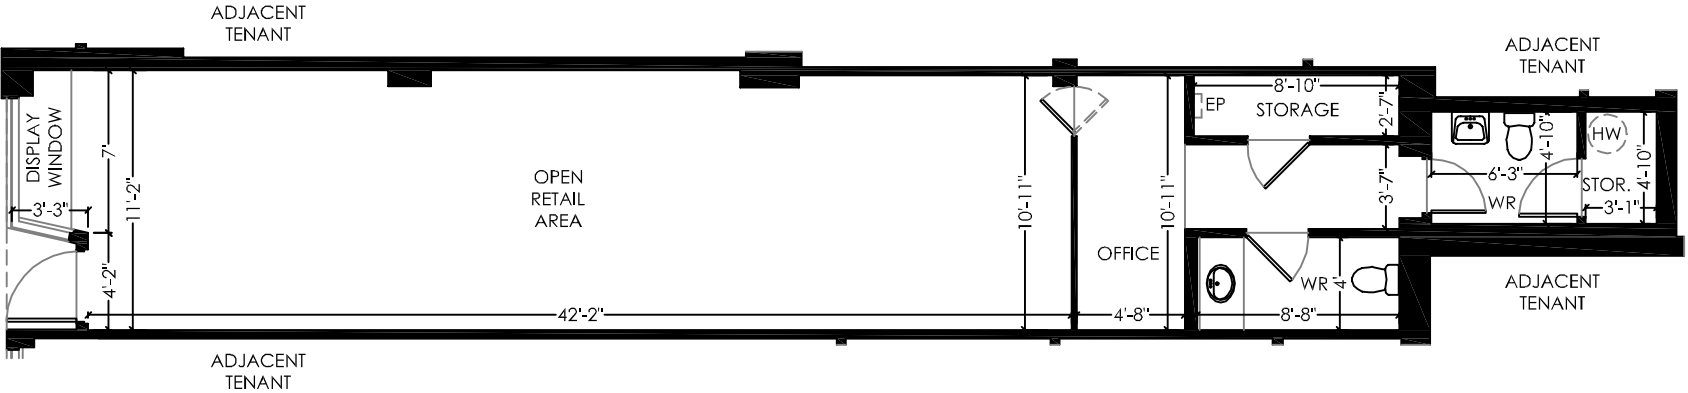

PREPARED BY: ECHOFLOORPLANS.COM

NOTE: SOME AREAS WERE NOT ACCESSIBLE TO MEASUREMENT