
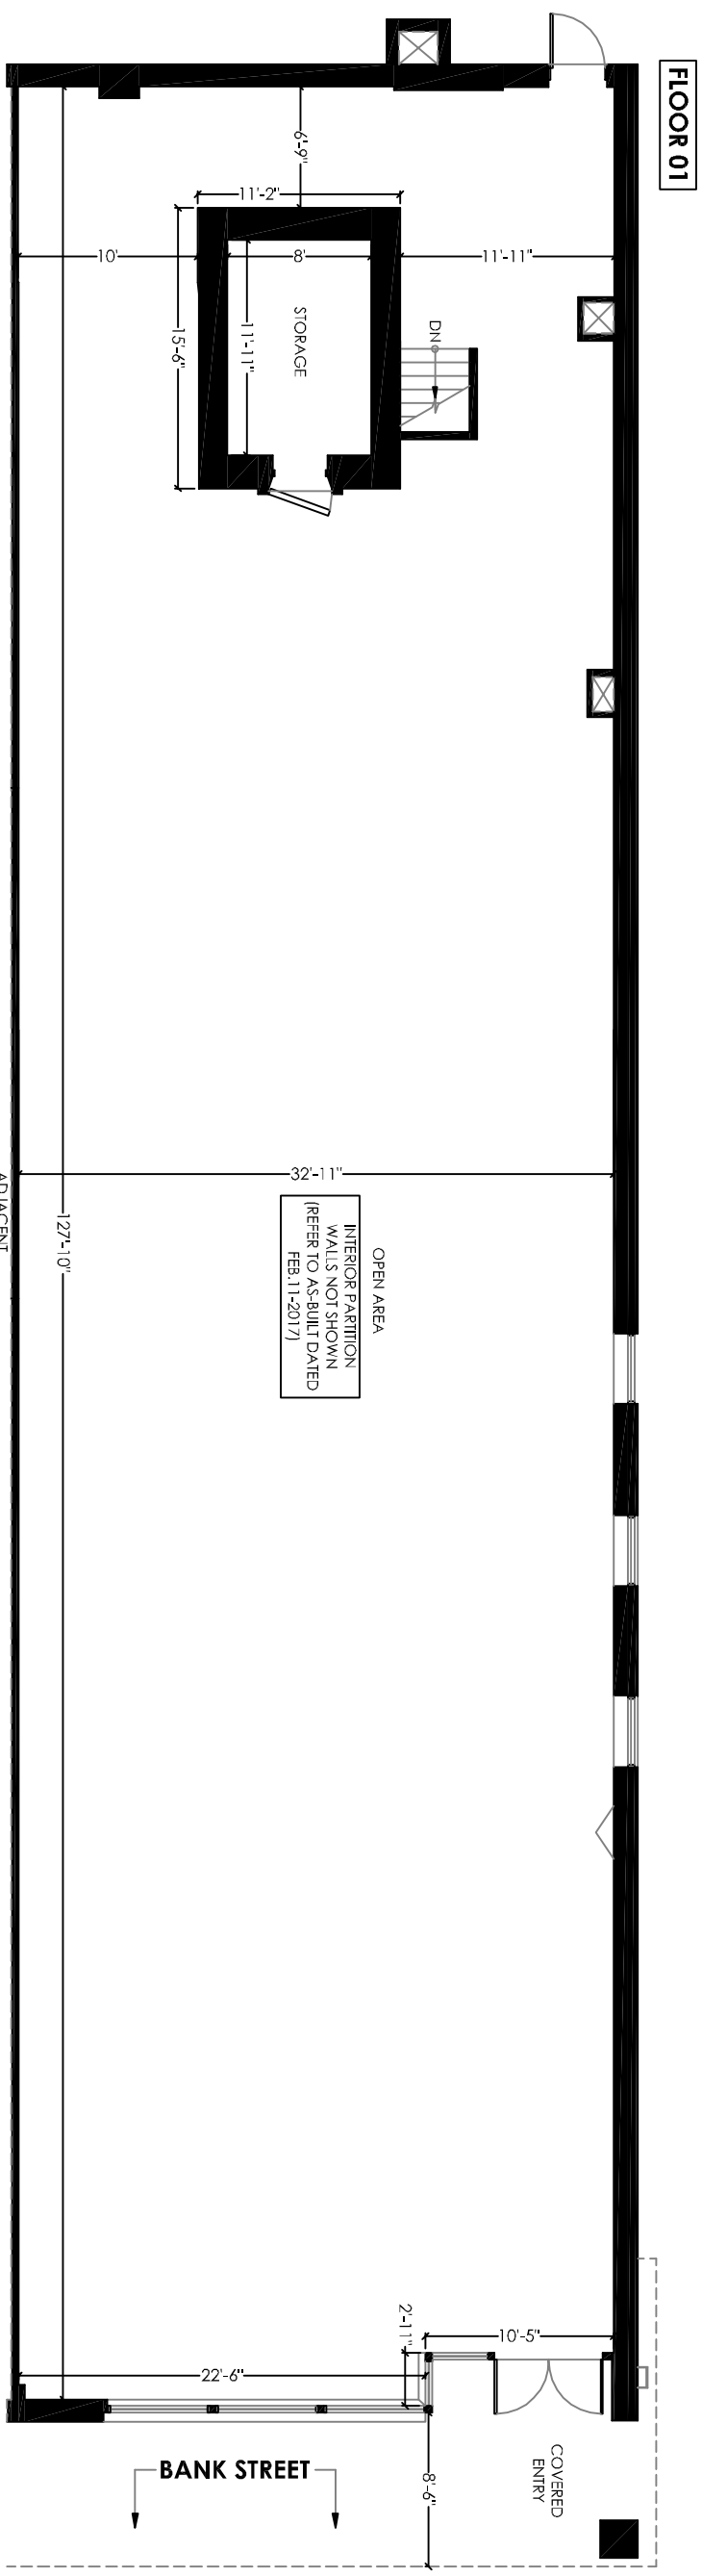
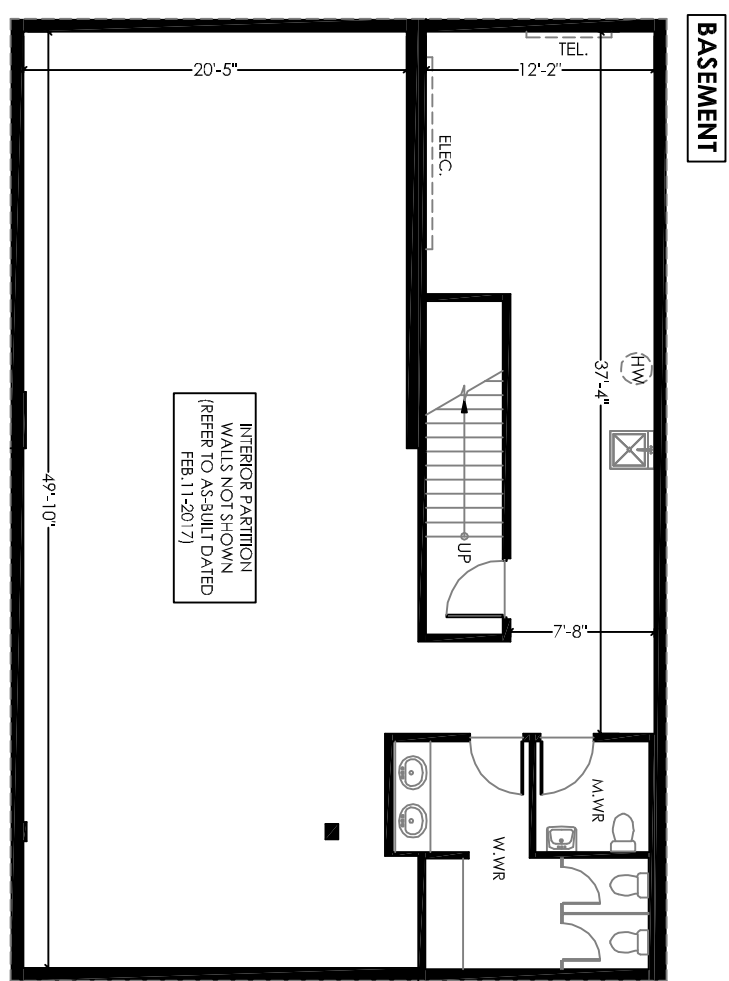


FLOOR 01 & BASEMENT

1529 BANK STREET, OTTAWA, ON
(AS-BUILT FLOOR PLANS)

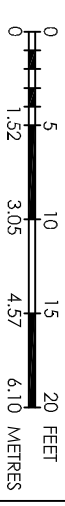


BANK STREET

COVERED ENTRY



- LEGEND:
- EXISTING WALLS
 - ELEC. ELECTRICAL
 - EP ELECTRICAL PANEL
 - HW HOT WATER TANK
 - TEL. TELECOMMUNICATIONS

PREPARED FOR: The Silver Group
 ADDRESS: 1529 Bank St., Ottawa, ON
 DATE: July 19, 2018
 REVISION: n/a
 PROJECT NUMBER: 2001166
 DRAWING SCALE: 1/4" = 1'-0" - Tabloid Size

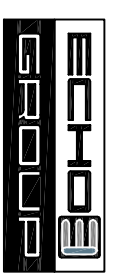

NOTE: SOME AREAS WERE NOT ACCESSIBLE TO MEASUREMENT

PREPARED BY: ECHO3GROUP.COM